

**TLCD ARCHITECTURE**

111 Santa Rosa Avenue, Suite 300  
Santa Rosa, CA 95404  
707-525-5600  
FAX 707-525-5616

**COST REQUEST**

DATE: May 7, 2007  
COST REQUEST NO. 1  
TO: McCrary Construction  
FROM: John Dybczak  
PROJECT: Napa Valley College Wine Storage Building  
PROJECT NO.: 05067.00

---

PLEASE SUBMIT AN ITEMIZED QUOTATION FOR CHANGES IN THE CONTRACT SUM AND/OR TIME INCIDENTAL TO PROPOSED MODIFICATIONS TO THE CONTRACT DOCUMENTS DESCRIBED HEREIN.

THIS IS NOT A CHANGE ORDER NOR A DIRECTION TO PROCEED WITH THE WORK DESCRIBED HEREIN.


---

Please provide a cost (per General Conditions, Item 28b) to relocate the existing 4" reclaimed water line at the north side of the building and the 2" reclaimed water line at the west side of the building to the outside of the over excavated area per the attached sketch R-1.

ATTACHMENTS: Drawing R-1

PC: Dan TerAvest, Bob Sims, Kurt Hirtzer, File 10b

OWNER'S RECORD DOCUMENT - FOR REFERENCE ONLY

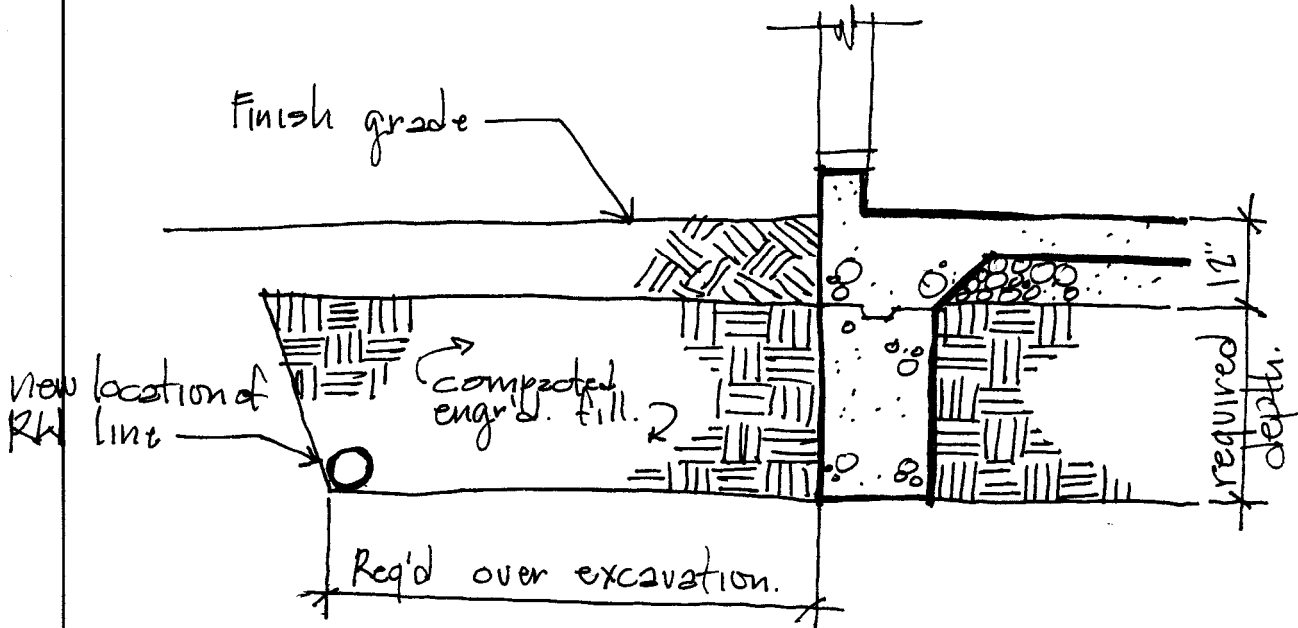

Section through North/West Walls  
 $\frac{1}{2}'' = 1'-0''$

NVC - Wine Storage Building.  
Cost Request 1.

Sheet R-1  
1 of 1



**TLCD ARCHITECTURE**

111 Santa Rosa Avenue, Suite 300  
Santa Rosa, CA 95404  
707-525-5600  
FAX 707-525-5616

**COST REQUEST**

DATE: May 23, 2007  
COST REQUEST NO. 2  
TO: McCrary Construction  
FROM: John Dybczak  
PROJECT: Napa Valley College Wine Storage Building  
PROJECT NO.: 05067.00

---

PLEASE SUBMIT AN ITEMIZED QUOTATION FOR CHANGES IN THE CONTRACT SUM AND/OR TIME INCIDENTAL TO PROPOSED MODIFICATIONS TO THE CONTRACT DOCUMENTS DESCRIBED HEREIN.

THIS IS NOT A CHANGE ORDER NOR A DIRECTION TO PROCEED WITH THE WORK DESCRIBED HEREIN.

---

Please provide a cost (per General Conditions, Item 28b) for the Owner's review to provide and install two 2" conduits from existing building 1700A to storage building for new EMS and fire alarm wiring per the attached drawing AE1.15.

ATTACHMENTS: Drawing AE1.15

PC: Dan TerAvest, Bob Sims, Kurt Hirtzer, File 10b


OWNER'S RECORD DOCUMENT - FOR REFERENCE ONLY

# NUMBERED SHEET NOTES

22 PROVIDE AND INSTALL TWO 2" CONDUITS FROM EXISTING BUILDING 1700A TO NEW STORAGE BUILDING FOR NEW EMS WIRING AND FUTURE FIRE ALARM WIRING.

23 PROVIDE AND INSTALL 2" CONDUIT FOR (F) FIRE ALARM USE.

24 PROVIDE AND INSTALL TWO 2" CONDUITS TO BUILDING D FOR FUTURE USE.

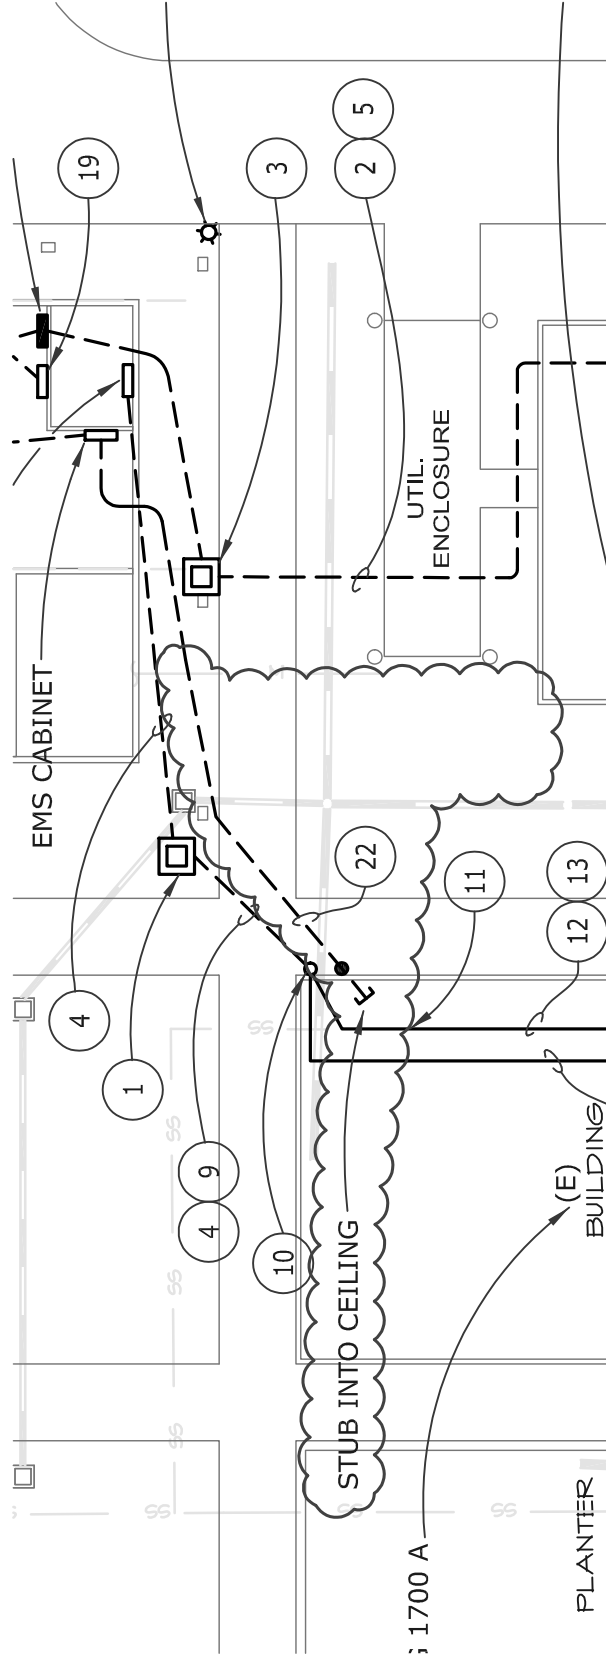

LCD ARCHITECTURE  
1 Santa Rosa Avenue, Suite 300  
Santa Rosa, CA 95404

T 707 525-5600  
II FAX 707 525-5616

PROJECT NAME  
**Napa Valley  
College Wine  
Storage Building**

PROJECT ADDRESS  
**2277 Napa-Vallejo  
Hwy.  
Napa, CA**

PROJECT NO:  
**05067.00**

DATE:  
**05-23-07**

BY:  
**RS**

DESCRIPTION:

REFERENCE:  
**E1.1  
SITE PLAN -  
ELECTRICAL**

Scale:  
**1" = 20'-0"**

DRAWING NO:

# AE1.15

OWNER'S RECORD DOCUMENT - FOR REFERENCE ONLY